


**CUEVA-CUBIO DE LA REÑADA**  
**Sites 0048 & 4221**

Resurvey and new surveys.

Survey: Matienzo Caves Project expeditions 2014 - now.  
Passages in green taken from 1992 survey.  
Surveyors: Dave Bell, Amy Burchell, James Carlisle, Juan Corrin, Jim Davis, Jess Eades, Peter Eagan, Peter Fast, Martyn Grayson, Richard Neal, Alasdair Neill, Phil Papard, John Proctor, Chris Sharnan, Carmen Smith, Peter Smith, Torben Redder, Alex Ritchie, Chris Scaffe.  
Drawn: Alasdair Neill 2014-2016, Juan Corrin, Phil Papard 2017.

**CUEVA DEL COMELLANTES**  
**site 0040**

Survey 2001 Jenny Corrin, Juan Corrin, Carolina Smith, Pete Smith  
additions August 2012  
Dave Bell, Peter Eagan, Alasdair Neill, Phil Papard, Terry Whitaker, 2015  
Sumps: Rupert Skorupka 1988, Chris Jewel and Laura Trowbridge 2012

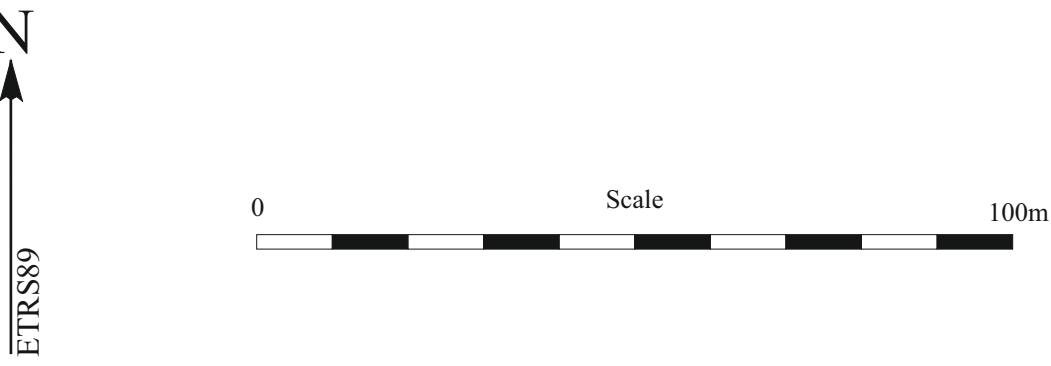

**NOTES:**  
Combined length after summer 2021 of all the joined caves in the South Vega System, including Reñada and Comellantes is 34783m (including 200m for unsurveyed 06/75. But see 21-01 note below)  
This does not take into account adjustments due to batch 17-03 (yearly air re-survey) which has yet to be drawn up on this survey.  
Batch 17-03 centre line is shown in red on original 2021s cdr survey file.  
Older drawn up surveys of parts of Reñada, eg Squimel's Passage (Pete Smith), have yet to be drawn onto this survey.  
JC 18/5/2017 - 2019: 29/9/2021

Batch code	Surveyors	Final drawing	Notes
19-02	Jess Eades, Martyn Grayson	Juan Corrin	N of Zeppelin Hangers
19-03	Jess Eades, Martyn Grayson	Juan Corrin	Zeppelin Hangers
19-04	Phil Papard, Peter Smith	Phil Papard	Itchy Crutch
21-01	Phil Papard, Peter Smith	Phil Papard	Itchy Crutch

System length has not been adjusted.  
This batch or older batches will require removal or \*FLAGS DUPLICATE.