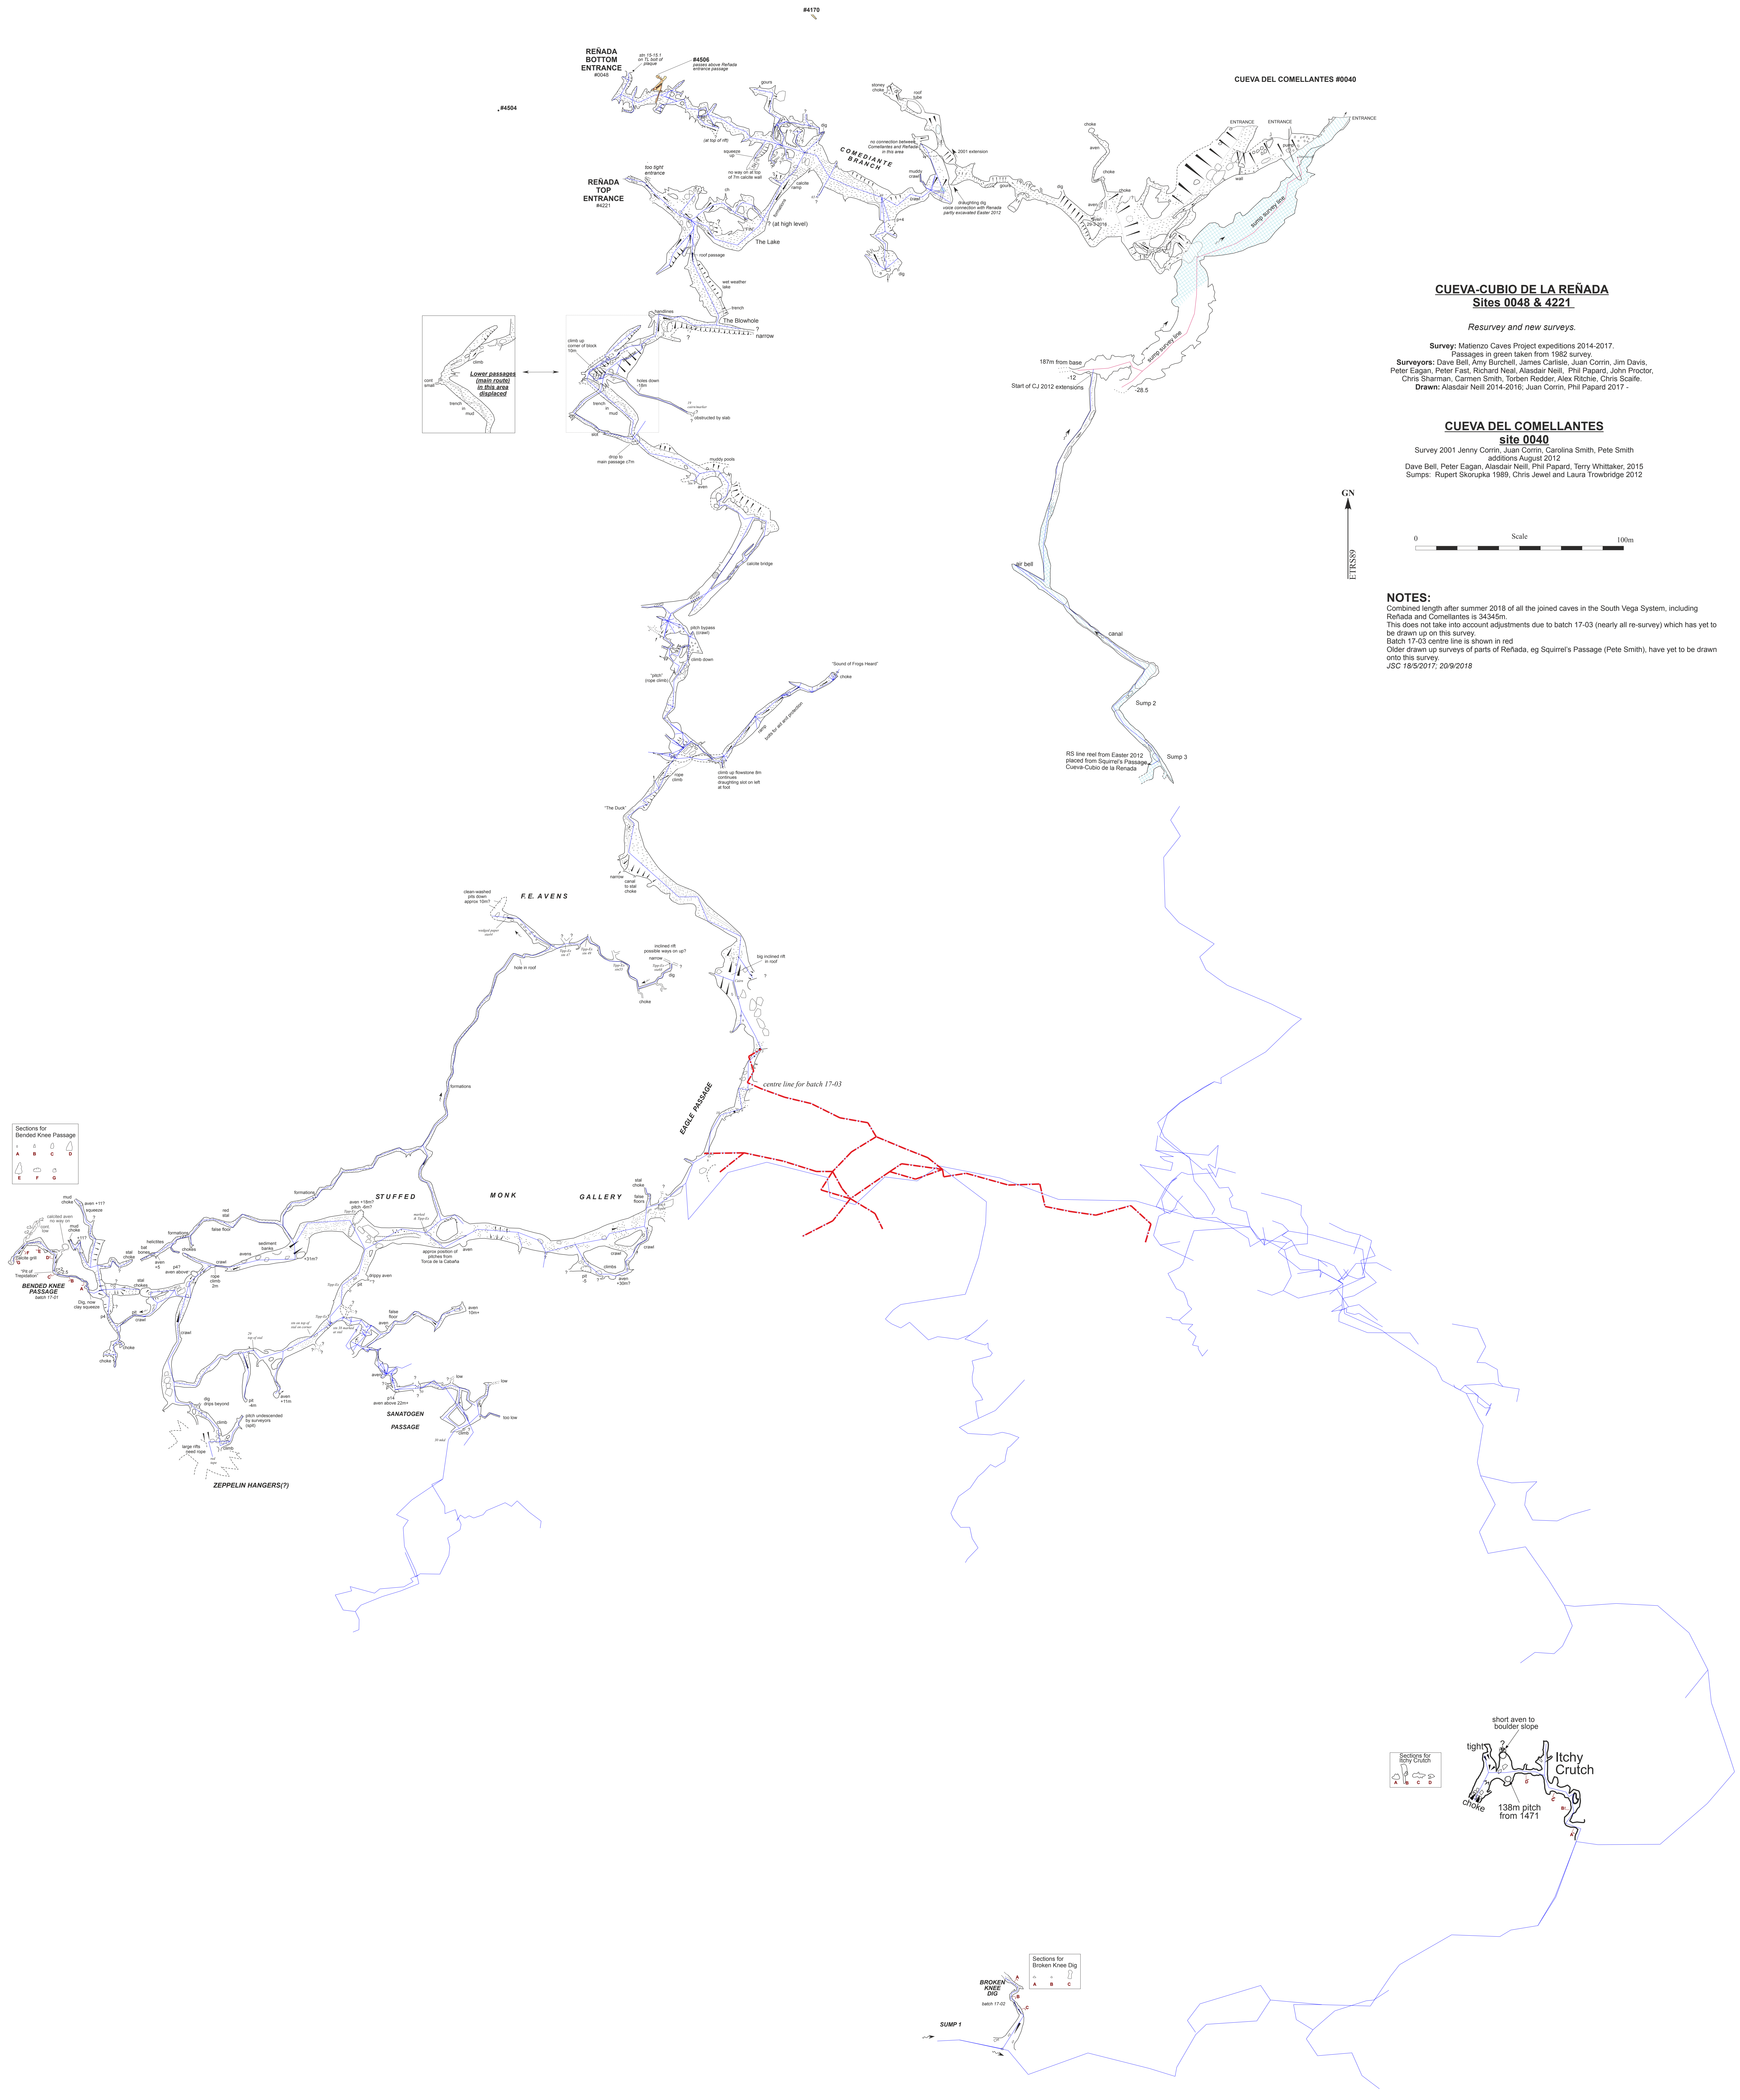

## CUEVA-CUBIO DE LA REÑADA
## Sites 0048 & 4221

*Resurvey and new surveys.*

**Survey:** Matienzo Caves Project expeditions 2014-2017.
Passages in green taken from 1982 survey.
**Surveyors:** Dave Bell, Amy Burchell, James Carlisle, Juan Corrin, Jim Davis, Peter Eagan, Peter Fast, Richard Neal, Alasdair Neill, Phil Papard, John Proctor, Chris Sharman, Carmen Smith, Torben Redder, Alex Ritchie, Chris Scaife.
**Drawn:** Alasdair Neill 2014-2016; Juan Corrin, Phil Papard 2017 -

## CUEVA DEL COMELLANTES
## site 0040

Survey 2001 Jenny Corrin, Juan Corrin, Carolina Smith, Pete Smith
additions August 2012
Dave Bell, Peter Eagan, Alasdair Neill, Phil Papard, Terry Whittaker, 2015
Sumps: Rupert Skorupka 1989, Chris Jewel and Laura Trowbridge 2012

## NOTES:

Combined length after summer 2018 of all the joined caves in the South Vega System, including Reñada and Comellantes is 34345m.
This does not take into account adjustments due to batch 17-03 (nearly all re-survey) which has yet to be drawn up on this survey.
Batch 17-03 centre line is shown in red
Older drawn up surveys of parts of Reñada, eg Squirrel's Passage (Pete Smith), have yet to be drawn onto this survey.
*JSC 18/5/2017; 20/9/2018*